GENERAL PLAN VIEW - SCALE 1:50

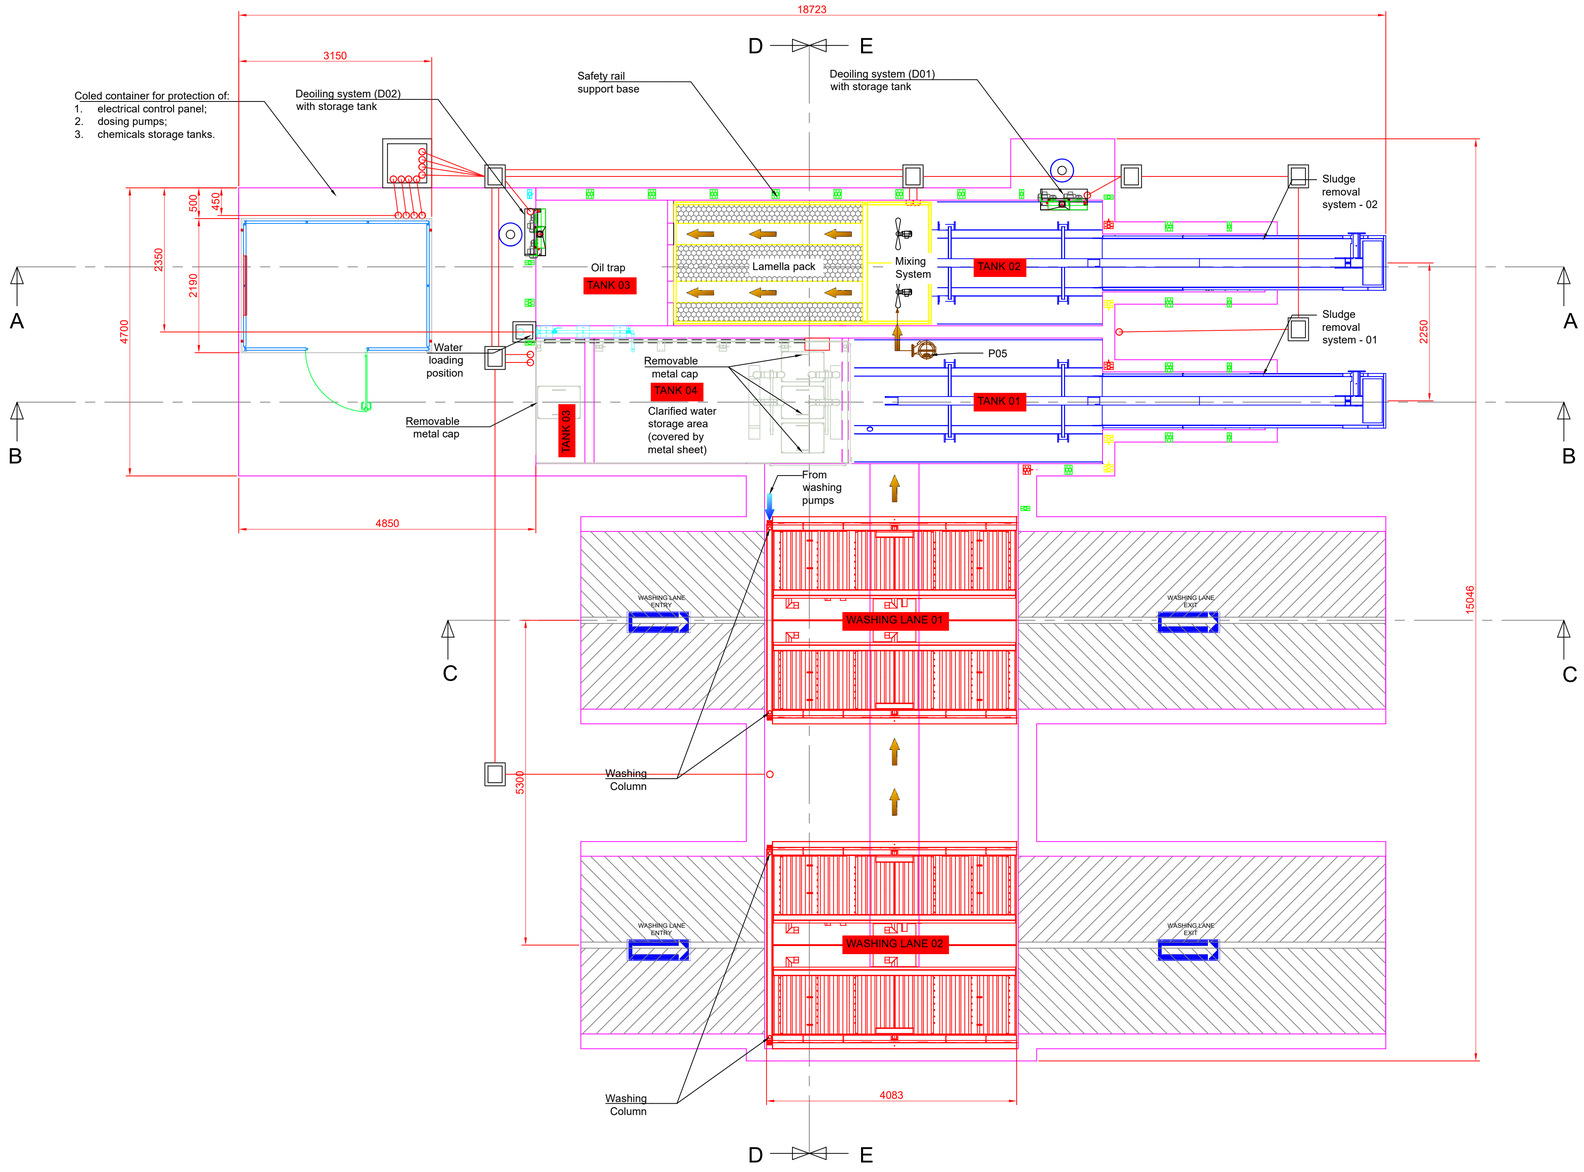

Safety Handrail - Scale 1:10

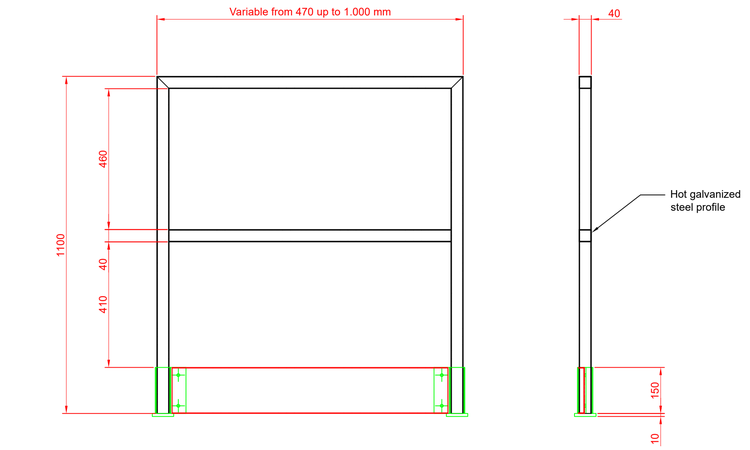

NOTE:

Make up water system will be installed, thanks to some brackets, above the concrete platform at around 20 cm from the ground level. Hole will be realized on the tank's cover to permitt refill of water.

MAKE UP WATER SYSTEM

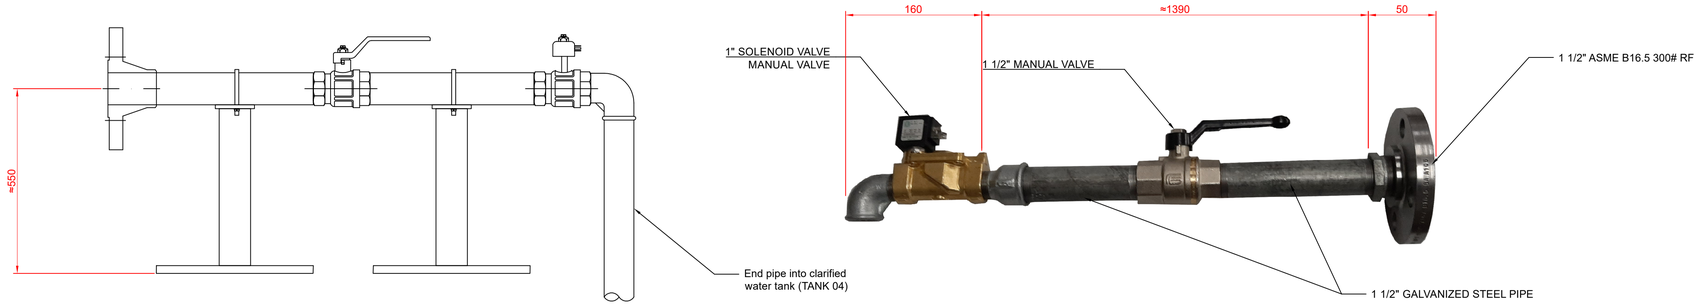

ANOPC — TECHNIP ENERGIES

PROJ.: ASSIUT HYDROCRACKING COMPLEX
OWNER: ASSIUT NATIONAL OIL PROCESSING COMPANY(ANOPC)

MATERIAL REQUISITION No.
079254C MR | 4 | 1 | 9 | 0 | – | 0 | 0 | 3
ITEM: 55-Z-001
SR Doc. CODE: A2001
PURCHASE ORDER N.: 079254A0166

VENDOR DOCUMENT REVIEW
- ☐ 1 REVISE AND RESUBMIT
- ☐ 2 TO BE ISSUED AS FINAL PROVIDED COMMENTS ARE INCORPORATED
- ☒ 3 NO COMMENT – FINAL ISSUE
- ☐ 4 FOR INFORMATION ONLY

jfazioli - May 29, 2023

clean

Drawing n.	Date	Commitment n°
A2001-GPV	18/11/2022	802-22

Rev.		Date		Mod. object	
Rev.	00	Date	18/11/2022	Mod. object	First emission
Rev.	01	Date	25/01/2023	Mod. object	Make up water drawing Safety handrail drawing
Rev.	02	Date	21/02/2023	Mod. object	Position of make up water changed
Rev.	03	Date	06/03/2023	Mod. object	Tank dimension updated Position of cooled container changed
Rev.	04	Date	17/05/2023	Mod. object	Position of separation wall into tank changed (100mm on the left)

Installation site	Assiut (EGY)	GAD - GENERAL PLAN VIEW WHEEL WASHING SYSTEM
Scale	---	
Drawn by	M.A.	Sign

Clean S.r.l.
Via Borgo Padova, 64
35012 Camposampiero (PD) - ITALY
www.clean-impianti.it
www.lavaruote.it
www.abbattimento-polveri.it
Tel. +39.049.9300500
fax +39.049.9320042

Customer

TECHNIP ENERGIES ITALY